

Date: Thursday, 7/20/2006 1:07:24 PM  
 User: Linda Lacelle

## Process Sheet

Customer	: CU-DAR001 Dart Helicopters Services	Drawing Name	: 350/212/130 BASKET LID
Job Number	: 27996B		
Estimate Number	: 10193		
P.O. Number	: N/A	Part Number	: D2512
This Issue	: 7/20/2006 S.O. No. : N/A	Drawing Number	: D2512 REV D2
Prsht Rev.	: NC	Project Number	: N/A
First Issue	: 7/20/2006 Type : LARGE FAB ASSY	Drawing Revision	: D2
Previous Run	: 27817B	Material	: N/A
Written By	: <u>See Comment Below</u>	Due Date	: 8/15/2006
Checked & Approved By	: <u>06.07.21</u>	Qty:	1 Um: Each
Comment	: Rev Est:M 03.01.31 Added D2012-117 for D130-701-041 KJ/ RF Est Rev:N 06.04.05 Added level21 EC		

## Additional Product

Job Number:



Seq. #:	Machine Or Operation:	Description :
---------	-----------------------	---------------

1.0	M304TS0750W065	304 SQ Tube.75x.75x.065W
-----	----------------	--------------------------



Comment: Qty.: 45.7594 f(s)/Unit Total : 45.7594 f(s)

Pick:

3/4"x3/4" 304/316 SS tube .063" wall

Batch: M01561

PD

06-08-02

①

2.0	D31663	Basket Hoop
-----	--------	-------------



Comment: Qty.: 1.0000 Each(s)/Unit Total : 1.0000 Each(s)

Pick:

Qty Part Number

Description

Batch

1 D3166-3

Basket Hoop

B22327

PD

06-08-02

①

3.0	D2506	Placard
-----	-------	---------



Comment: Qty.: 1.0000 Each(s)/Unit Total : 1.0000 Each(s)

Pick:

Qty Part Number

Description

Batch

1 D2506

Label Plate

B26631.2

PD

06-08-09

①

4.0	D23271	Spacer Bushing
-----	--------	----------------



Comment: Qty.: 2.0000 Each(s)/Unit Total : 2.0000 Each(s)

Pick:

Qty Part Number

Description

Batch

2 D2327-1

Bushing

B26742

PD

06-08-09

①

W/O:		WORK ORDER CHANGES					
DATE	STEP	PROCEDURE CHANGE	By	Date	Qty	Approval Mfg / Design Mgr	Approval QC Inspector

NCR:		WORK ORDER NON-CONFORMANCE (NCR)						
DATE	STEP	Description of NC Section A	Corrective Action Section B			Verification Section C	Approval Design Mgr	Approval QC Inspector
			Initial Design Mgr	Action Description Design Mgr	Sign & Date			

Part No: \_\_\_\_\_ PAR #: \_\_\_\_\_ Fault Category: \_\_\_\_\_ NCR: Yes No DQA: \_\_\_\_\_ Date: \_\_\_\_\_

NOTE: Date & initial all entries

QA: N/C Closed: \_\_\_\_\_ Date: \_\_\_\_\_

Date: Thursday, 7/20/2006 1:07:24 PM  
User: Linda Lacelle

## Process Sheet

Customer: CU-DAR001 Dart Helicopters Services

Drawing Name: 350/212/130 BASKET LID

Job Number: 27996B

Part Number: D2512

Job Number:



Seq. #:	Machine Or Operation:	Description :
---------	-----------------------	---------------

5.0	D22321	Hinge
-----	--------	-------



Comment: Qty.: 2.0000 Each(s)/Unit Total : 2.0000 Each(s)

Pick:

Qty	Part Number	Description	Batch
2	D2232-1	Hinge plate	626238

PD 06-08-09 (1)

6.0	D2581	Mounting Bracket
-----	-------	------------------



Comment: Qty.: 2.0000 Each(s)/Unit Total : 2.0000 Each(s)

Pick:

Qty	Part Number	Description	Batch
2	D2581	Mounting Bracket	627524

PD 06-08-09 (1)

7.0	M304EX07516F	Expanded Metal Flat Stai
-----	--------------	--------------------------



Comment: Qty.: 18.0000 sf(s)/Unit Total : 18.0000 sf(s)

Pick:

Qty	Part Number	Description	Batch
18 sf	M304EX0.75-16F	Expanded Metal	1101707

PD 06-08-09 (1)

8.0	LARGE FAB 1	LARGE FABRICATION RESOURCE 1
-----	-------------	------------------------------



Comment: LARGE FABRICATION RESOURCE 1

1-Cut 3/4" x 3/4" square tubing as per Dwg D2512

2-Cut (4) D2236 From D3166-3

3-Drill holes in D2512-1 as per Dwg D2512 using Drill Jig DT8305

5-Weld as per Dwg D2512 using Welding Table and corner Jig Deburr as required

PD 06-08-09 (1)

9.0	QC9/6	DDIMENSIONAL & WELDING INSPECTION
-----	-------	-----------------------------------



Comment: DDIMENSIONAL & WELDING INSPECTION

PD 06/08/09 (1)

W/O:		WORK ORDER CHANGES					
DATE	STEP	PROCEDURE CHANGE	By	Date	Qty	Approval Mfg / Design Mgr	Approval QC Inspector

NCR:		WORK ORDER NON-CONFORMANCE (NCR)						
DATE	STEP	Description of NC Section A	Corrective Action Section B			Verification Section C	Approval Design Mgr	Approval QC Inspector
			Initial Design Mgr	Action Description Design Mgr	Sign & Date			

Part No: \_\_\_\_\_ PAR #: \_\_\_\_\_ Fault Category: \_\_\_\_\_ NCR: Yes No DQA: Q Date: 06/08/17

NOTE: Date & initial all entries

QA: N/C Closed: \_\_\_\_\_ Date: \_\_\_\_\_

Date: Thursday, 7/20/2006 1:07:24 PM  
User: Linda Lacelle

## Process Sheet

Customer: CU-DAR001 Dart Helicopters Services

Drawing Name: 350/212/130 BASKET LID

Job Number: 27996B

Part Number: D2512

Job Number:



Seq. #: Machine Or Operation: Description :

10.0 POWDER COATING POWDER COATING



Comment: POWDER COATING

Powder Coat White Gloss (Ref: 4.3.5.1) as per QSI 005 4.3

SC 06/08/14 ①

11.0 HAND FINISHING1 HAND FINISHING RESOURCE #1



Comment: HAND FINISHING RESOURCE #1

Wing Walk and Spray Paint black as per Dwg D2512 and QSI 005 4.4

Batch: M101667

a.m. 06-08-15

①

12.0 QC3 INSPECT POWDER COAT/CHEMICAL CONVERSION



Comment: INSPECT POWDER COAT/CHEMICAL CONVERSION

SB

M.F. 06-08-15

①

13.0 PACKAGING 1 PACKAGING RESOURCE #1



Comment: PACKAGING RESOURCE #1

Identify and Stock

Location: GA

SB 06/08/15

①

14.0 DC DOCUMENT CONTROL



Comment: DOCUMENT CONTROL

Inspection Level 21

① 06/08/17

Job Completion



4 06-08-17

W/O:		WORK ORDER CHANGES					
DATE	STEP	PROCEDURE CHANGE	By	Date	Qty	Approval Mfg / Design Mgr	Approval QC Inspector

NCR:		WORK ORDER NON-CONFORMANCE (NCR)						
DATE	STEP	Description of NC Section A	Corrective Action Section B			Verification Section C	Approval Design Mgr	Approval QC Inspector
			Initial Design Mgr	Action Description Design Mgr	Sign & Date			

Part No: \_\_\_\_\_ PAR #: \_\_\_\_\_ Fault Category: \_\_\_\_\_ NCR: Yes No DQA: \_\_\_\_\_ Date: \_\_\_\_\_

NOTE: Date & initial all entries

QA: N/C Closed: \_\_\_\_\_ Date: \_\_\_\_\_




DESIGN BW	DRAWN BY CP	DART AEROSPACE LTD HAWKESBURY, ONTARIO, CANADA	
CHECKED #	APPROVED #	DRAWING NO. D2512	REV. D SHEET 1 OF 4
DATE 01.04.19		TITLE BASKET LID ASSEMBLY (350/212) SCALE NTS	
A	95.11.21	NEW ISSUE	
B	96.05.24	ADDED LATCH CHANNEL & LABEL PLATE	
C	99.07.06	REMOVE DOUBLE SKIN SECTION, ADDED MEMBERS, INCORP. DEO 9074	
D	01.04.19	CHANGE HINGE	
D1	CP 03.01.20	ADD D2012-117 FOR D130-701-041	
D2	CP 04.09.20	TACK WELD ANT-SKID AREA	

RELEASED  
01.04.27 #

PARTS LIST FOR D2512 BASKET LID ASSEMBLY

PART NO	QUANTITY	LENGTH A	LENGTH B	DESCRIPTION
D2512-1	2	—	25.50	RIB
D2512-3	2	—	95.30	RIB
D2512-5	6	30.84	—	RIB
D2512-7	3	30.63	—	RIB
D2232-1	2	N/A	N/A	HINGE PLATE
D2236	4	N/A	N/A	RIB
D2327-1	2	N/A	N/A	BUSHING
D2506	1	N/A	N/A	LABEL PLATE
D2581	2	N/A	N/A	MOUNTING BRKT

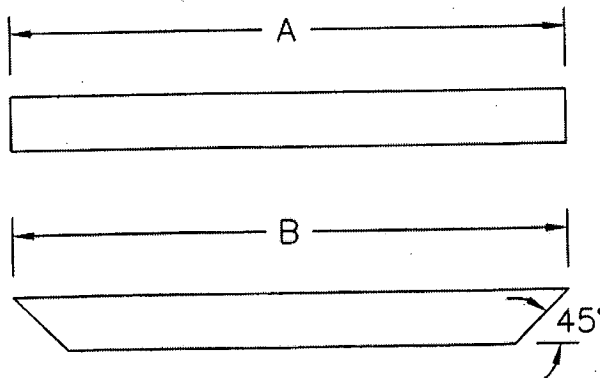

D2512-1/-3/-5/-7

CUT LENGTH/SHAPE PER DIAGRAM AND PARTS LIST

MATERIAL: AISI 304/316 SS, 3/4 X 3/4 X 0.060 WALL SQUARE TUBING

TOLERANCES ARE PER DART QSI 018 UNLESS OTHERWISE NOTED

ALL DIMENSIONS ARE IN INCHES

SHOP COPY  
RETURN TO  
ENGINEERING  
UNCONTROLLED COPY  
SUBJECT TO AMENDMENT  
WITHOUT NOTICE  
WORK ORDER  
NO. 27996B


Copyright © 1995 by DART AEROSPACE LTD

THIS DOCUMENT IS PRIVATE AND CONFIDENTIAL AND IS SUPPLIED ON THE EXPRESS CONDITION THAT IT IS NOT TO BE USED FOR ANY PURPOSE OR COPIED OR COMMUNICATED TO ANY OTHER PERSON WITHOUT WRITTEN PERMISSION FROM DART AEROSPACE LTD.

**DART**

NOT FOR CONSTRUCTION

DESIGN	BW	DRAWN BY	JC	DART AEROSPACE LTD HAWKESBURY, ONTARIO, CANADA
CHECKED	<i>[Signature]</i>	APPROVED	<i>[Signature]</i>	DRAWING NO. D2512
DATE	01.04.19			SHEET 2 OF 4
				REV. D
				SCALE 1:20
				TITLE BASKET LID ASSEMBLY (350/212)

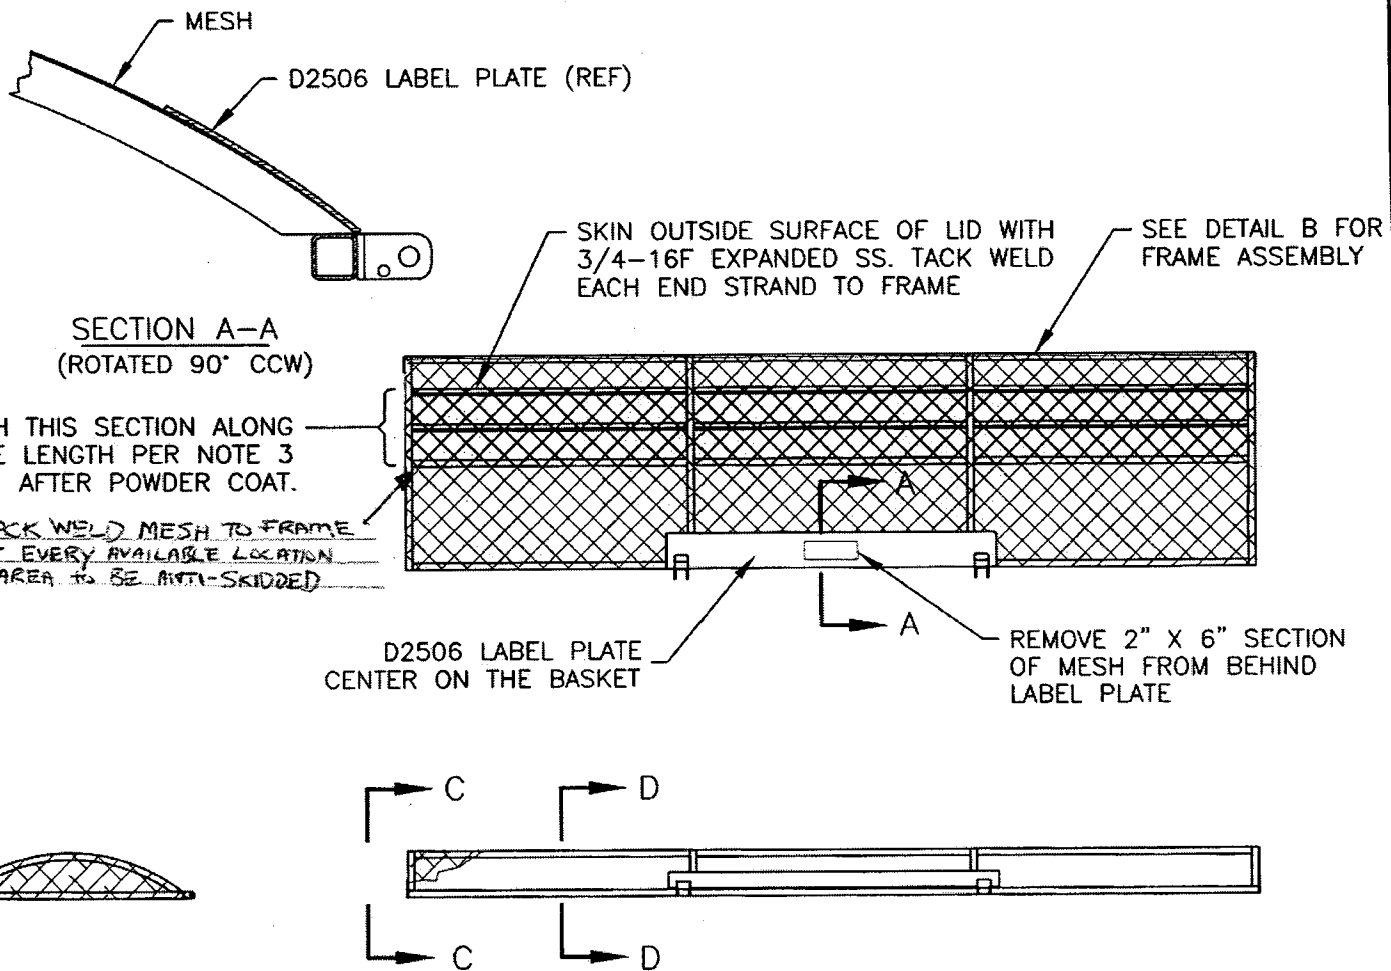

**D2512 BASKET LID ASSEMBLY**

- 1) MESH MATERIAL: 3/4-16F EXPANDED SS
- 2) FINISH: POWDER COAT ENTIRE ASSEMBLY WHITE (4.3.5.2) PER DART QSI 005 4.3
- 3) SPRAY PAINT BLACK INSIDE SURFACE  
APPLY BLACK ANTI-SKID TO OUTSIDE SURFACE PER DART QSI 005 4.4
- 4) TOLERANCES ARE PER DART QSI 018 UNLESS OTHERWISE NOTED
- 5) ALL DIMENSIONS ARE IN INCHES

RELEASED  
NO. 219965  
WORKBOOK  
CONTROLLED COPY  
RETURN TO  
ENGINEERING  
SHOP COPY



Copyright © 1995 by DART AEROSPACE LTD  
THIS DOCUMENT IS PRIVATE AND CONFIDENTIAL AND IS SUPPLIED ON THE EXPRESS CONDITION THAT IT IS NOT TO BE USED FOR ANY PURPOSE OR COPIED OR COMMUNICATED TO ANY OTHER PERSON WITHOUT WRITTEN PERMISSION FROM DART AEROSPACE LTD.



**DART**



DESIGN	DRAWN BY	DART AEROSPACE LTD
BW	UP	HAWKESBURY, ONTARIO, CANADA
CHECKED	APPROVED	DRAWING NO.
01.04.19		D2512
DATE	TITLE	SHEET 3 OF 4
	BASKET LID ASSEMBLY (350/212)	SCALE
		1:20

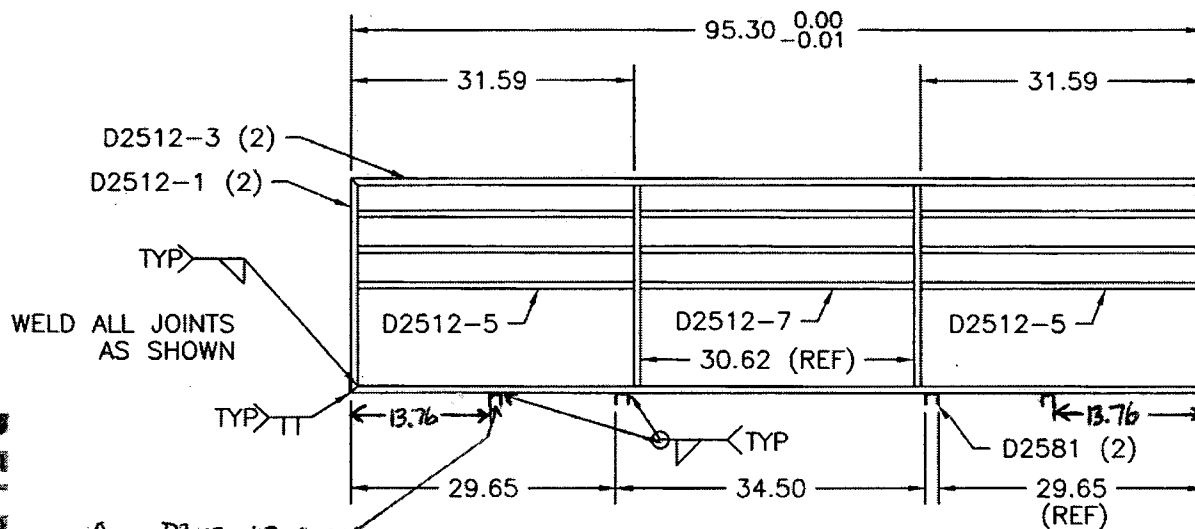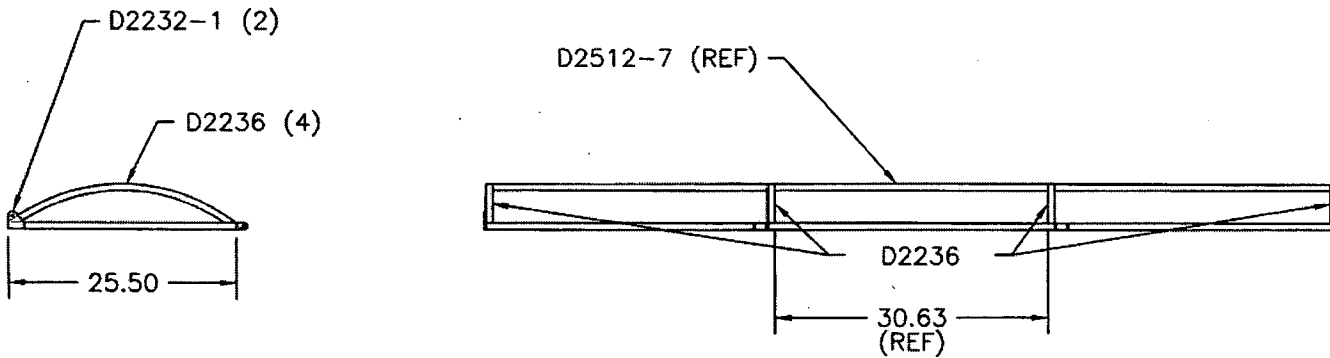

D2012-117 CLEMS  
ADD FOR D130-701-041  
ONLY (2 PLACES)

**DETAIL B**  
FRAMEWORK SHOWN FOR CLARITY  
TOLERANCES ARE PER DART QSI 018 UNLESS OTHERWISE NOTED  
ALL DIMENSIONS ARE IN INCHES

NO. 27996B

WORK ORDER

RELEASED

ENGINEERING

RETURN TO

STOP COPY


10.04.2019

10.04.2019


10.04.2019




DESIGN BW	DRAWN BY CP	DART AEROSPACE LTD HAWKESBURY, ONTARIO, CANADA	
CHECKED #	APPROVED #	DRAWING NO. D2512	REV. D SHEET 4 OF 4
DATE 01.04.19		TITLE BASKET LID ASSEMBLY (350/212)	SCALE 1:8

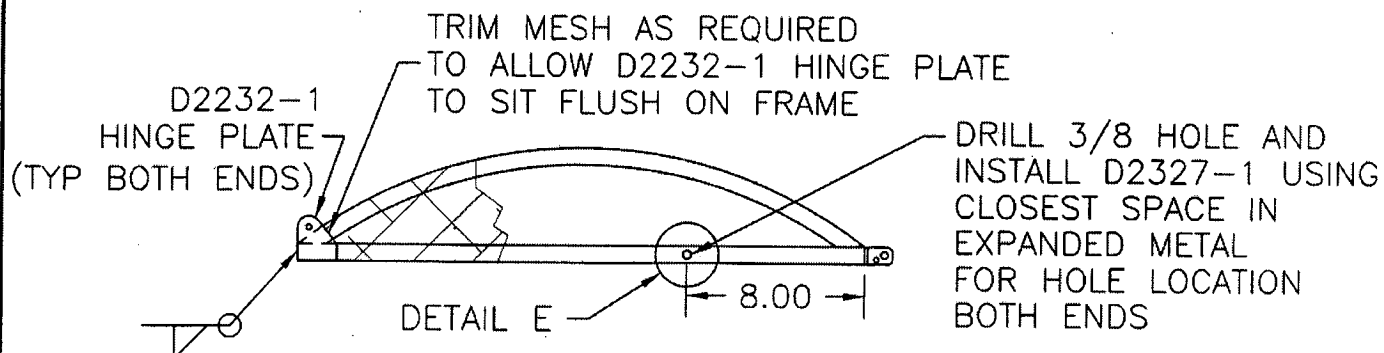

SECTION C-C SIMILIAR BOTH END RIBS

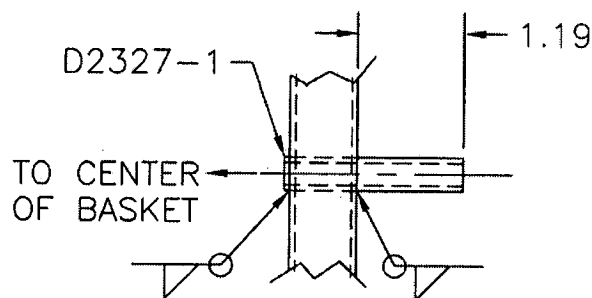

DETAIL E

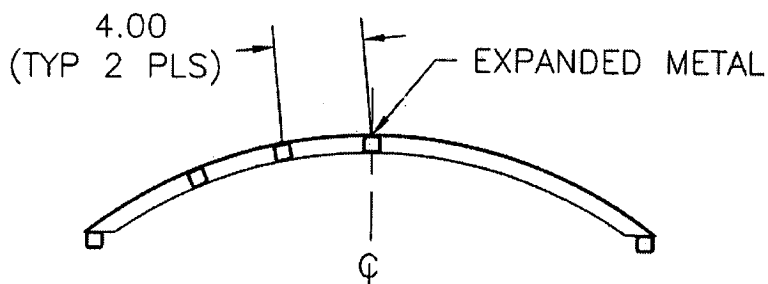

SECTION D-D SAME BOTH CENTER RIBS

SHOP COPY  
RETURN TO  
ENGINEERING  
UNCONTROLLED COPY  
SUBJECT TO AMENDMENT  
WITHOUT NOTICE  
WORK ORDER  
NO. 27996B

Copyright © 1995 by DART AEROSPACE LTD

THIS DOCUMENT IS PRIVATE AND CONFIDENTIAL AND IS SUPPLIED ON THE EXPRESS CONDITION THAT IT IS NOT TO BE USED FOR ANY PURPOSE OR COPIED OR COMMUNICATED TO ANY OTHER PERSON WITHOUT WRITTEN PERMISSION FROM DART AEROSPACE LTD.